
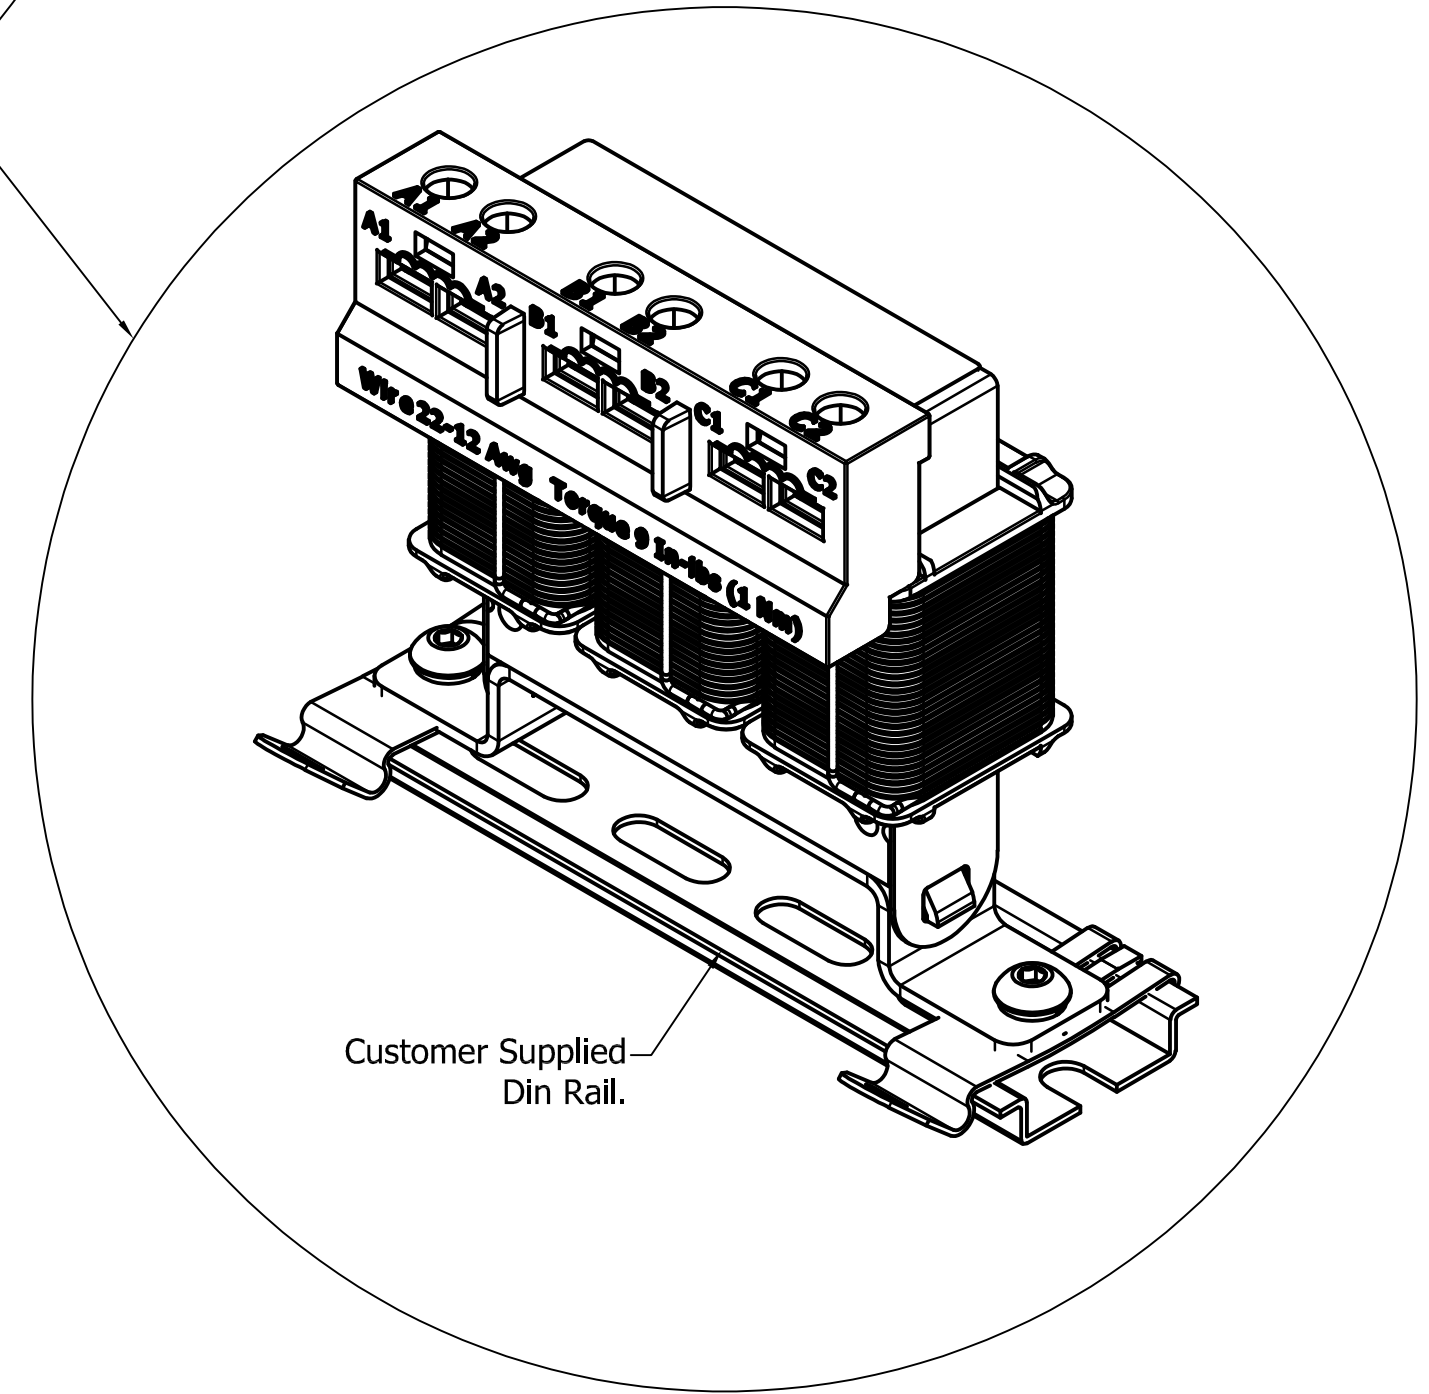
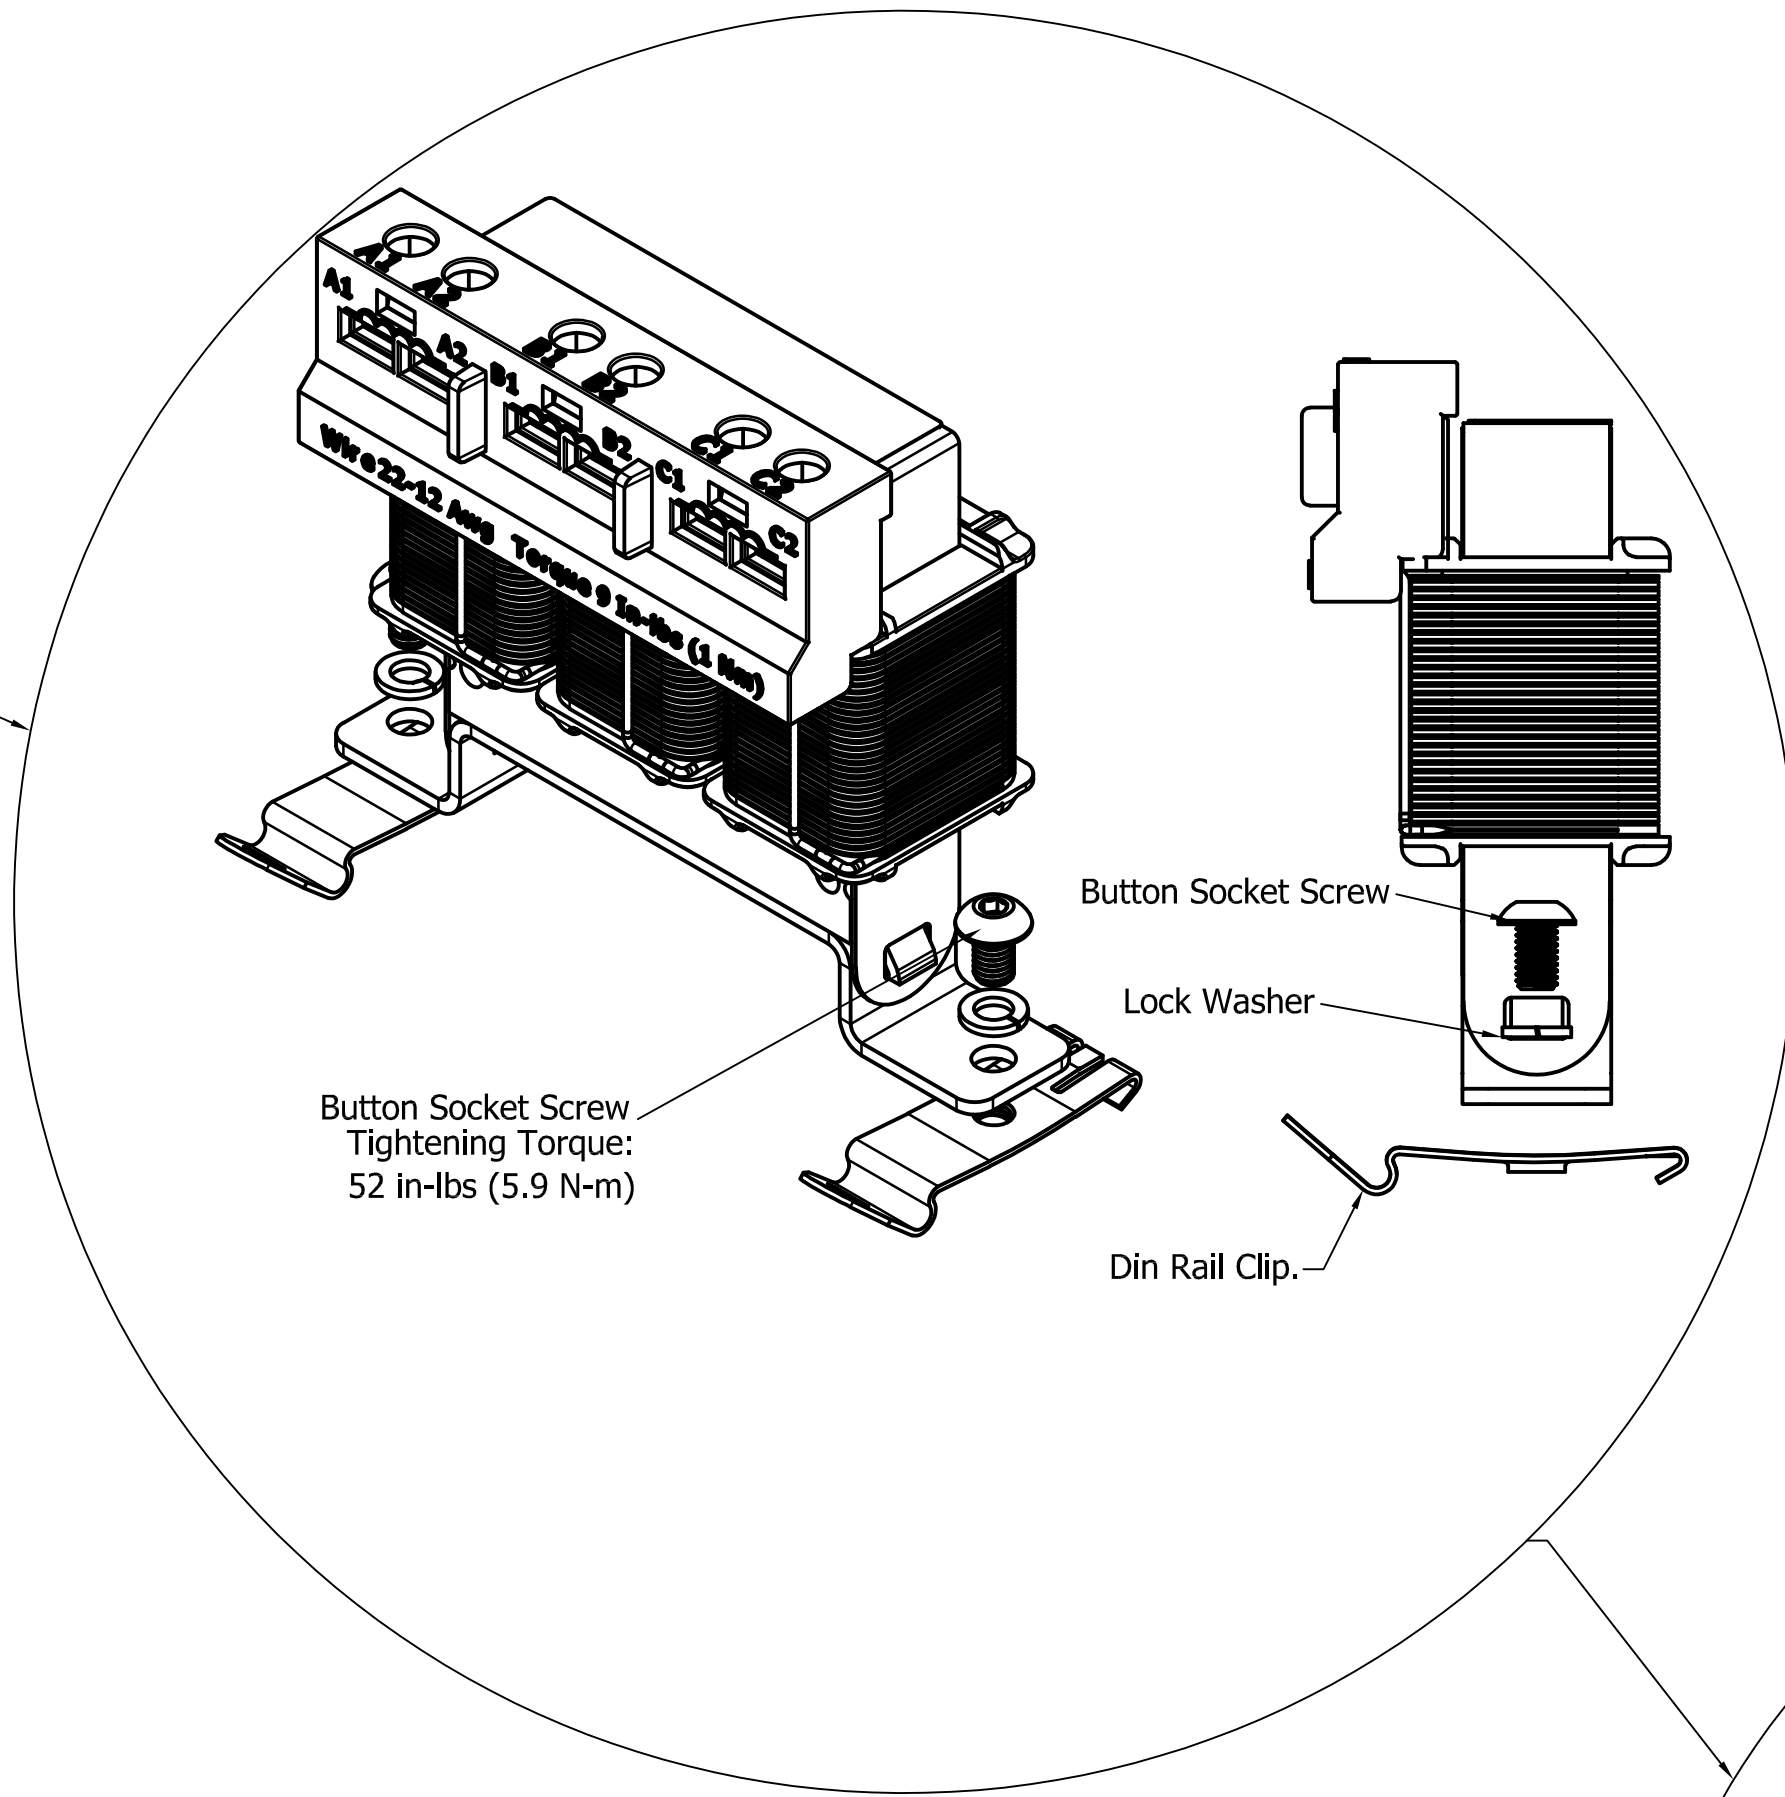


TCI PART# DR01

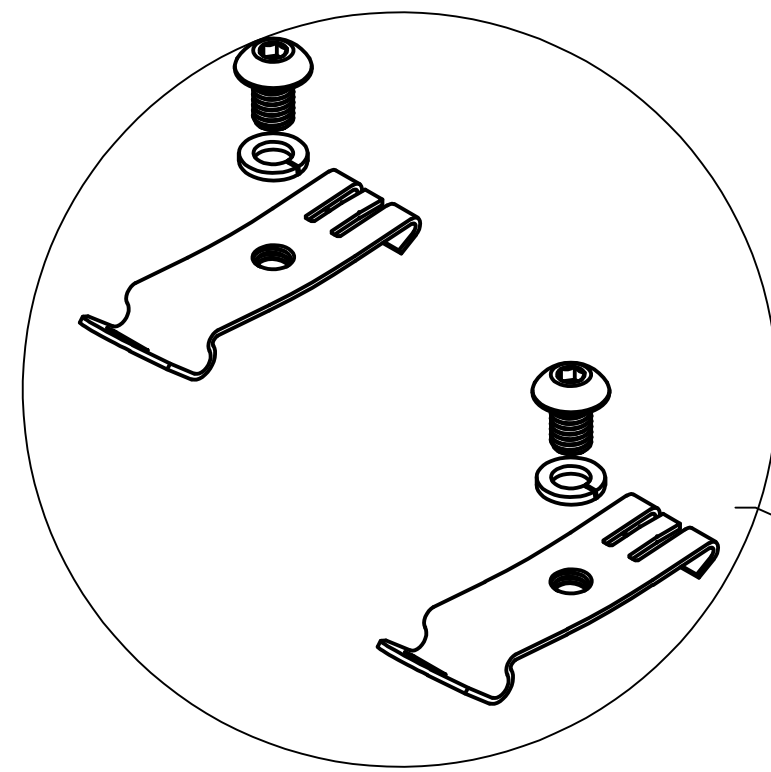

Customer Is Responsible For Installation to Meet All National And Local Electrical Codes.

Material(s) Shall be RoHS Compliant

TCI, LLC CLAIMS PROPRIETARY RIGHTS IN THE MATERIAL HEREIN DISCLOSED. IT IS SUPPLIED WITHOUT PREDJUDICE TO ANY PATENT RIGHTS OF TCI AND MAY NOT BE REPRODUCED OR USED TO MANUFACTURE ANYTHING SHOWN THEREIN WITHOUT WRITTEN PERMISSION FROM TCI.

					TOLERANCES (EXCEPT AS NOTED)
					DECIMAL
					.XX +/- .25
					.XXX +/- .10
					FRACTIONAL
					+/- 1/16
					ANGULAR
					+/- 1°
NO	REVISION	DATE	BY		
A	AS BUILT	10/24/17	DSW		

TCI W132 N10611 Grant Drive
 Germantown, WI. 53022

(DR01), KDRMA, Din Rail,
 Mounting Clips And Hardware Kit.

DRN. BY: DSW DATE: 10/24/17 DWG. No.: 30830
 SCALE: 1:1 APRVD. SHEET 1 OF 1